

COUNTY OF MENDOCINO

Executive Office

Facilities & Fleet Division

CARMEL J. ANGELO CHIEF EXECUTIVE OFFICER

851 Low Gap Road Email:johnsonj@mendocinocounty.org Office: (707) 234-6050 Ukiah, CA 95482 Website: www.co.mendocino.ca.us Fax: (707) 463-4673

ADDENDUM #: 01

PROJECT: 81-17 - Administration Center (South Wing) Roof and HVAC

Replacement Project

DATE: 11-28-2017

ISSUED BY: Doug Anderson

The additions, omissions, clarifications, and/or corrections herein shall be made part of the Contract plans and specifications and shall be included in the Scope of Work and proposals to be submitted. This Addendum modifies the original plans and specifications as described below.

- 1. The date for opening bids is changed to Tuesday December 12th at 2:00 PM; 851 Low Gap Road, Ukiah, CA.
- One additional opportunity to attend a Mandatory Pre-bid Conference and Site Walkthrough will be held on Tuesday December 5th at 1:00 PM at the project site, 860 N. Bush St., Ukiah, CA.


INQUIRIES AND CLARIFICATIONS TO PROJECT PLANS AND SPECIFICATIONS

- 3. Q: Mechanical drawing M303 is missing from the bid set. M304 is posted twice. Can you post missing drawing M303?
 - A: Yes, the corrected bid set has been posted to our website and the missing sheet is included in this addendum.
- 4. Q: Specification Section 015000 Temporary Construction and Building Services Chapter 1.3, Heading A, Paragraph1a refers to a phasing plan. No phasing plan was included with the project documents. Where can the phasing plan be found.
 - A: The suggested phasing plan is posted to the County Website for Bidding opportunities for this project (81-17) under the Additional Information Folder. The Contractor shall submit it's proposed phasing plan for approval prior to the start of work.
- 5. Q: Please define "curb" as shown on E2.01/Panelboard Mounting Freestanding -Roof. Keynote #2 says "Panel shall be free standing from clearstory. Provide curb, unistrut mounting bracket and all accessory equipment necessary."
 - A: Revise Detail 2/E2.01 per attached SK00 through SK03.

ADDITIONAL INFORMATION

- 6. Sign in Sheets for the Pre-bid Conferences held on 11-9 and 11-20 are attached and posted to the County webpage for this project.
- 7. The Pre-Renovation Hazardous Materials Assessment for Asbestos and Lead Containing Materials for this project has been completed and is posted to the County webpage for this project.

Bidders are reminded that they shall complete the Addenda Acknowledgement in the Bid Form of their Specification Book (Section 00310-2). Failure to do so may result in disqualification of the submitted bid.

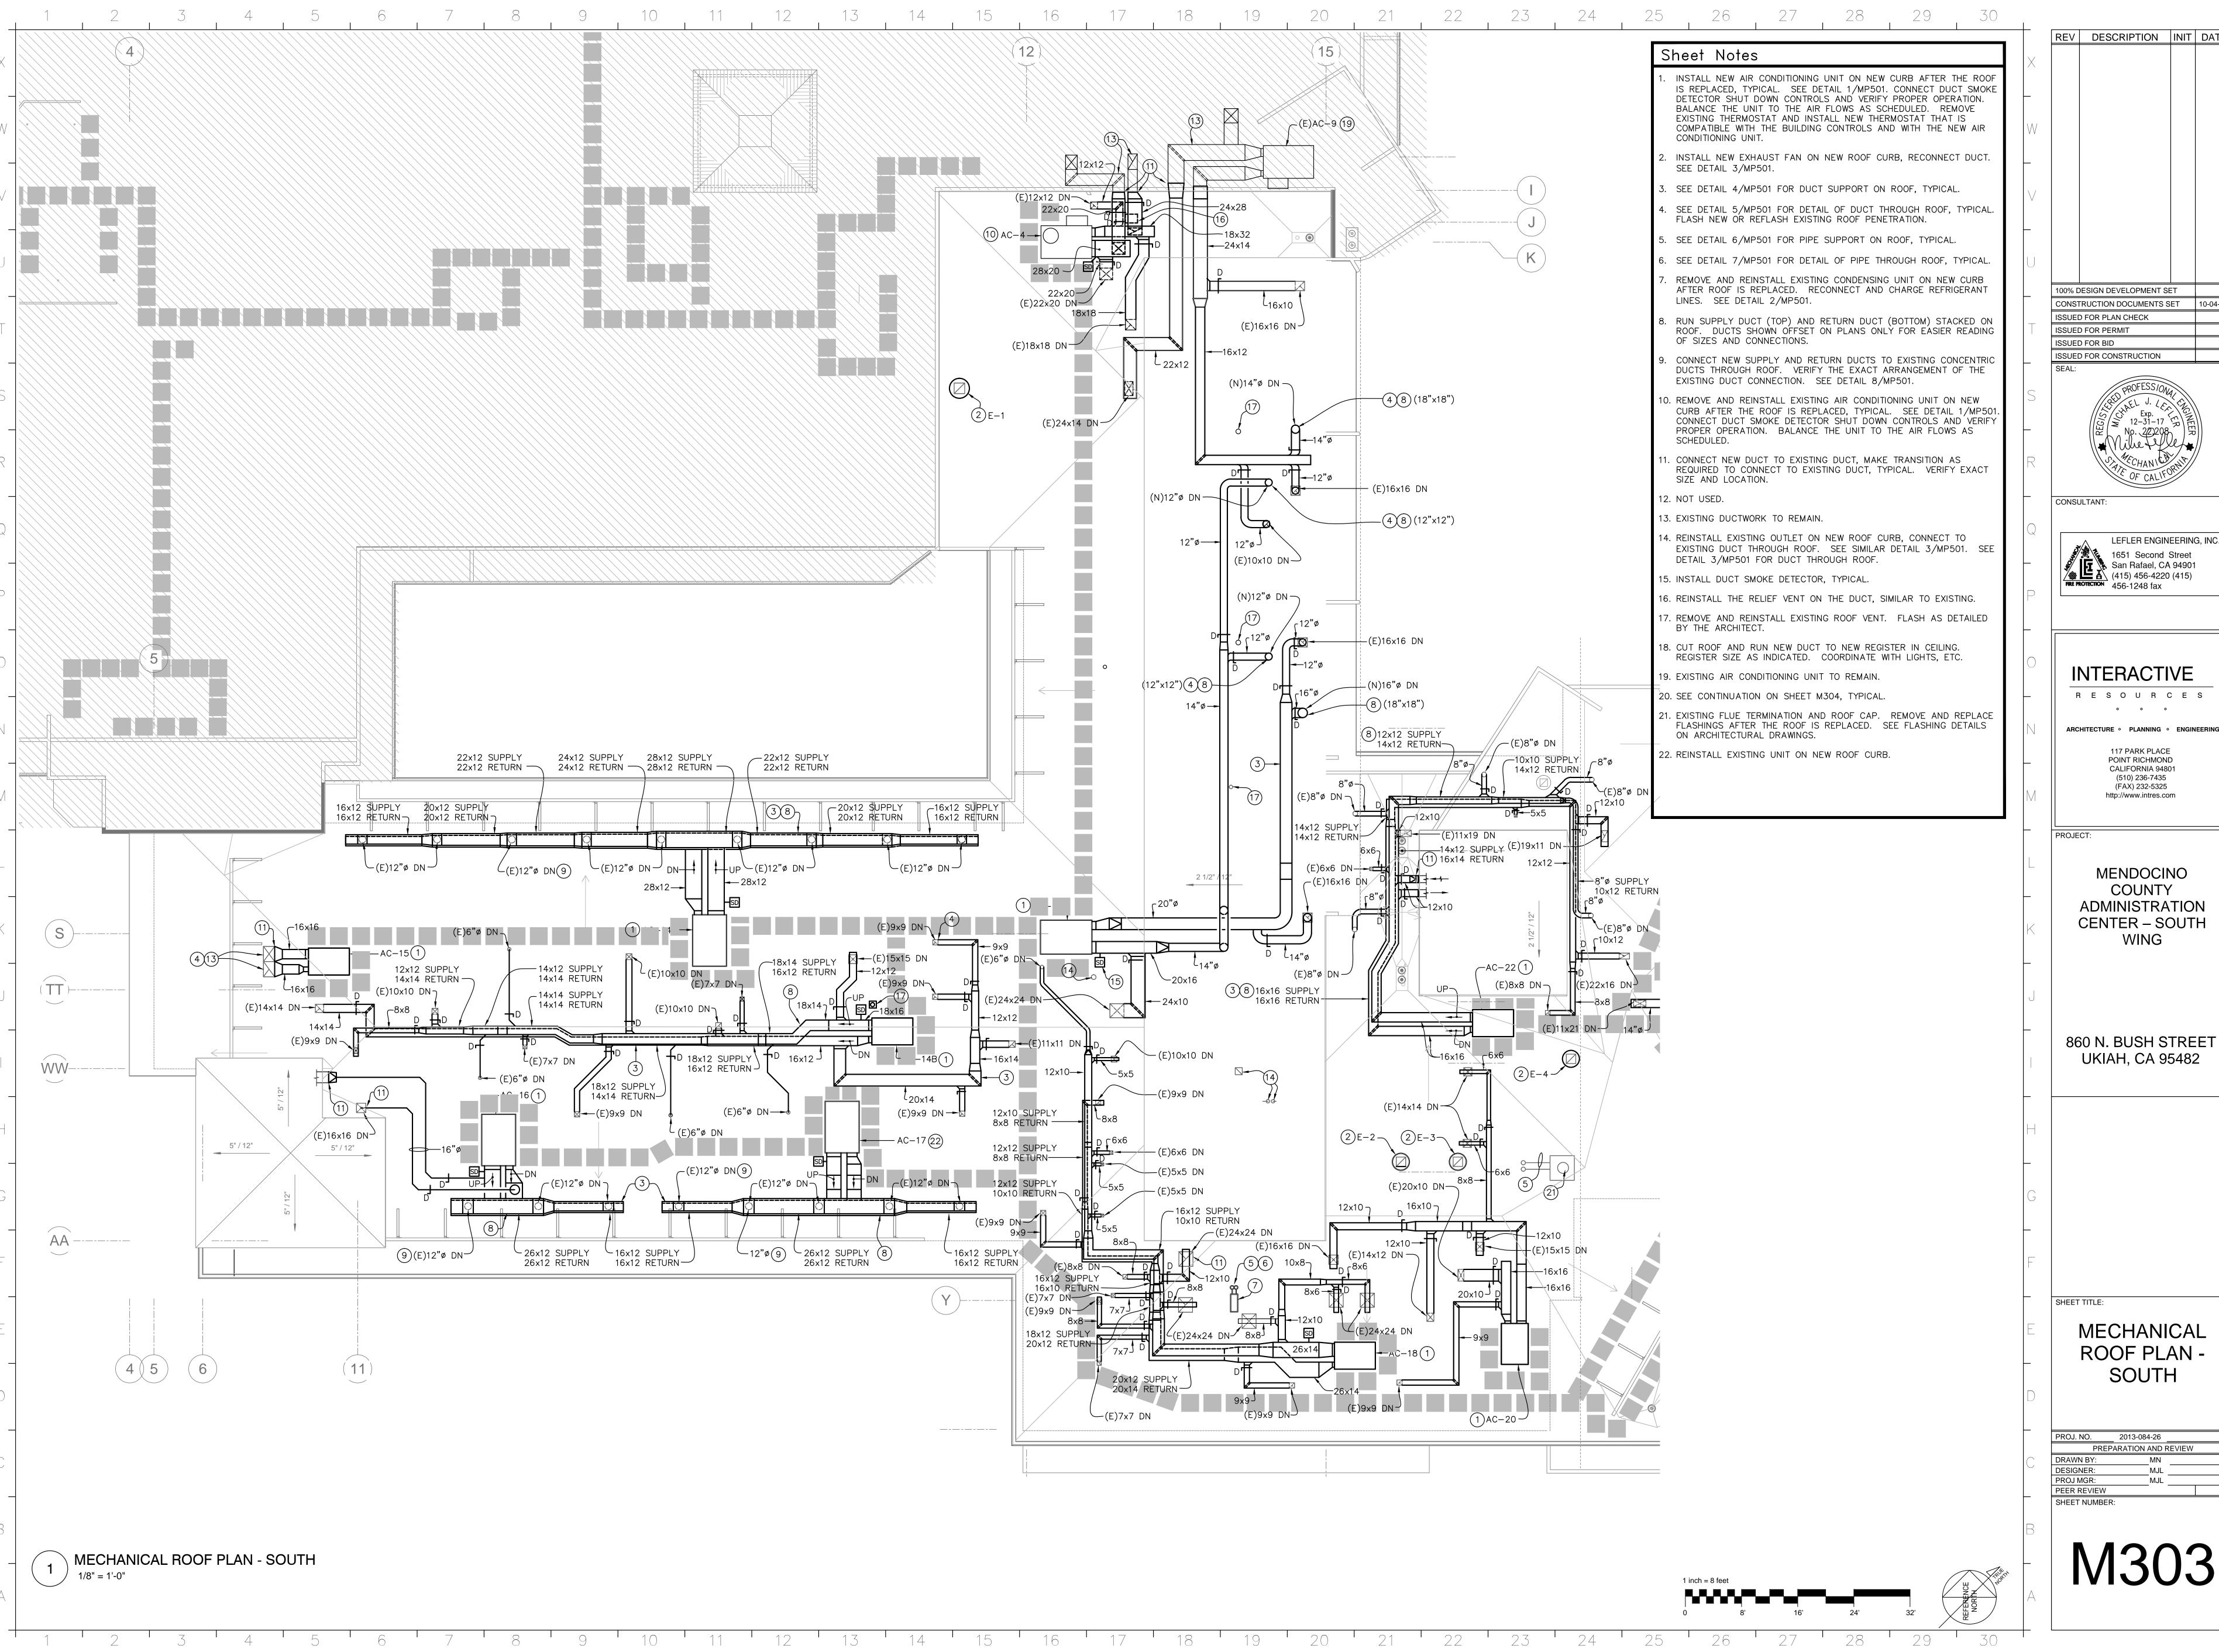

| REV | DESCRIPTION | INIT | DATE 100% DESIGN DEVELOPMENT SET

CONSTRUCTION DOCUMENTS SET ISSUED FOR PLAN CHECK ISSUED FOR PERMIT ISSUED FOR CONSTRUCTION



CONSULTANT:



INTERACTIVE R E S O U R C E S

0 0 0

117 PARK PLACE POINT RICHMOND CALIFORNIA 94801 (510) 236-7435 (FAX) 232-5325 http://www.intres.com


MENDOCINO COUNTY **ADMINISTRATION** CENTER - SOUTH WING


860 N. BUSH STREET UKIAH, CA 95482


SHEET TITLE:


MECHANICAL ROOF PLAN -SOUTH


___ 2013-084-26 PREPARATION AND REVIEW PROJ MGR: PEER REVIEW

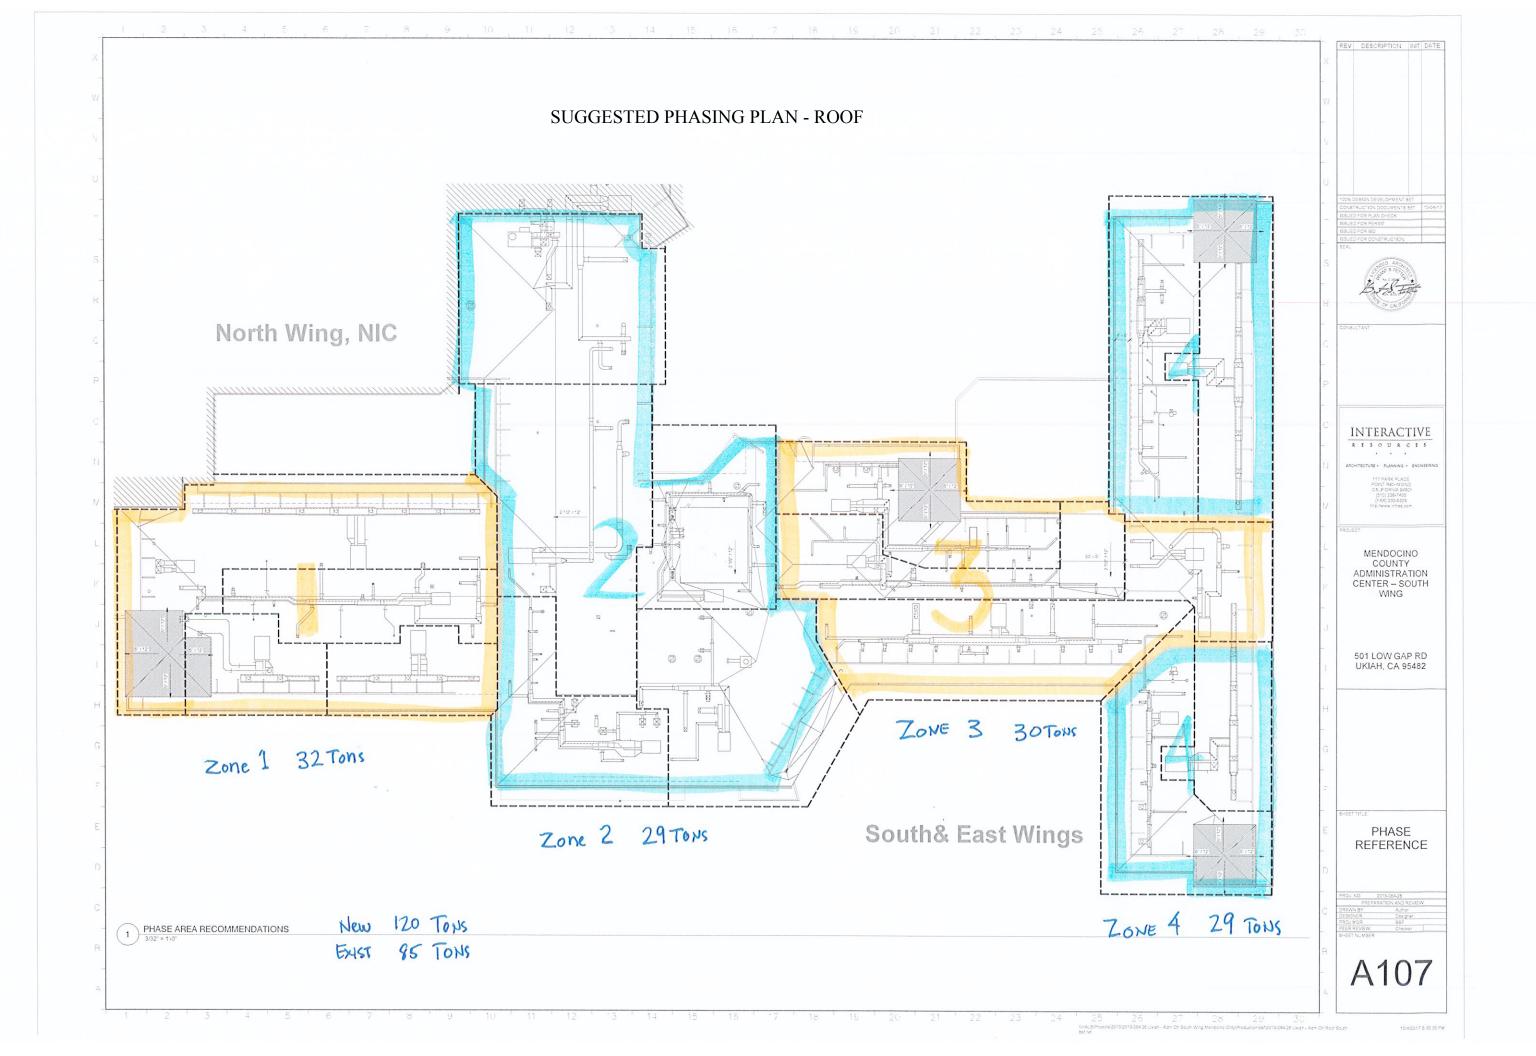

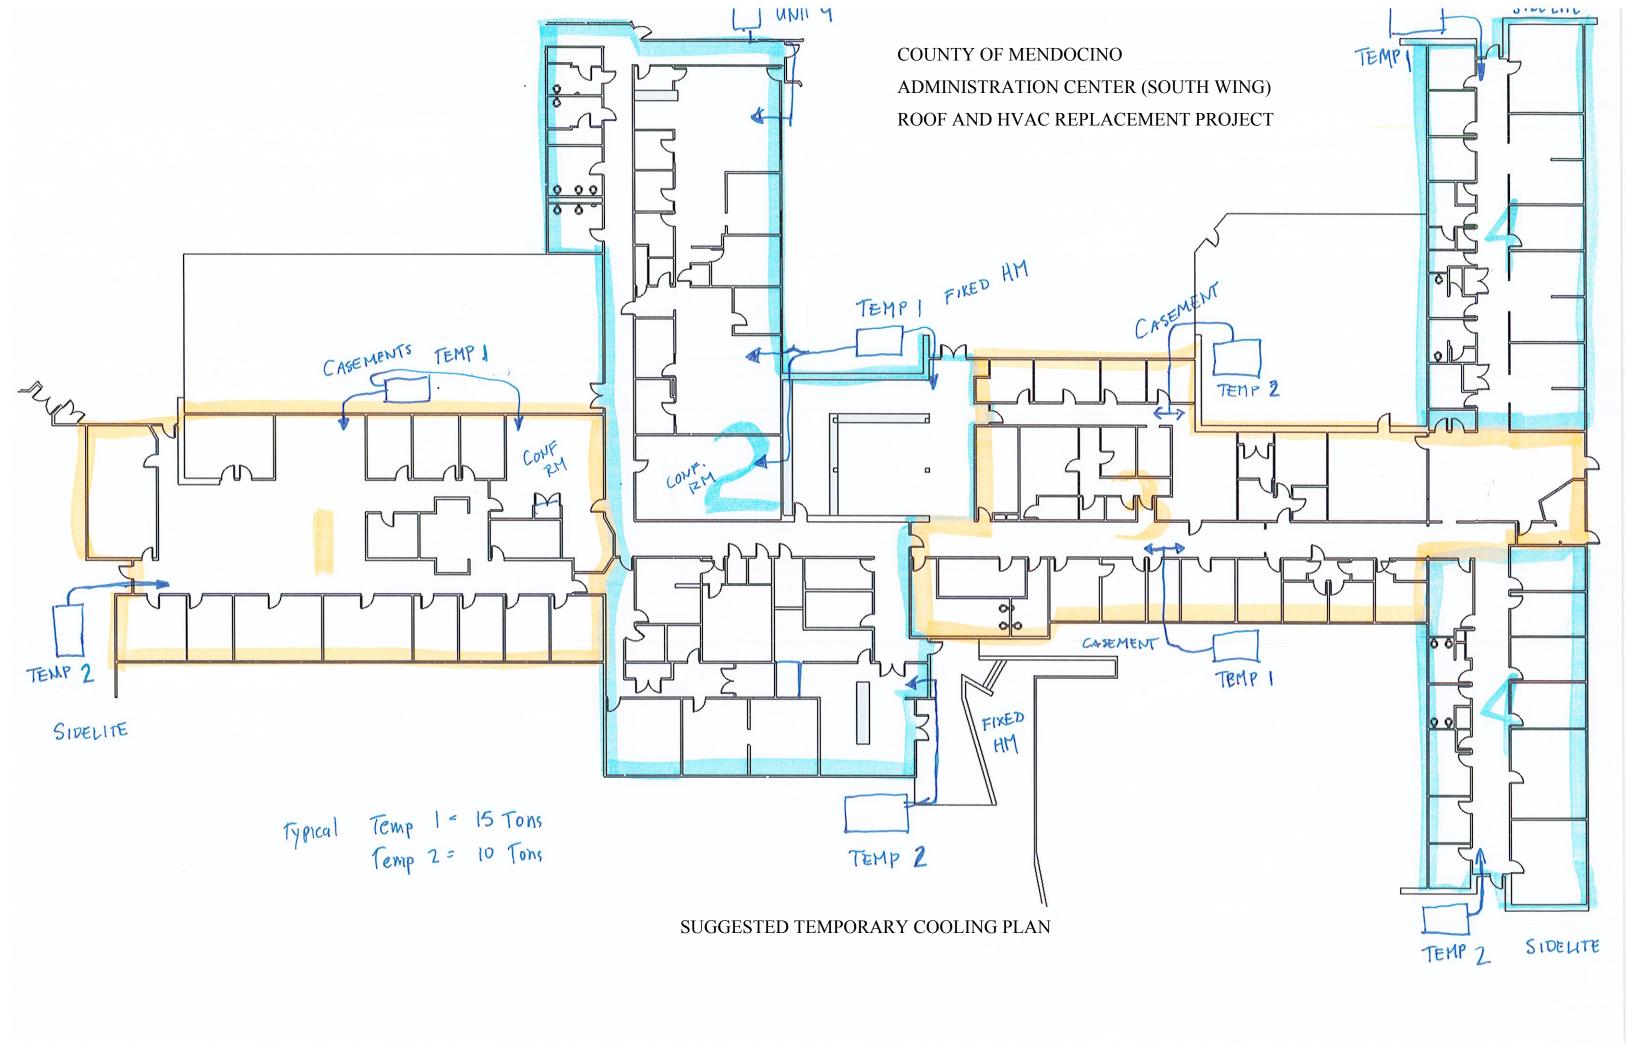

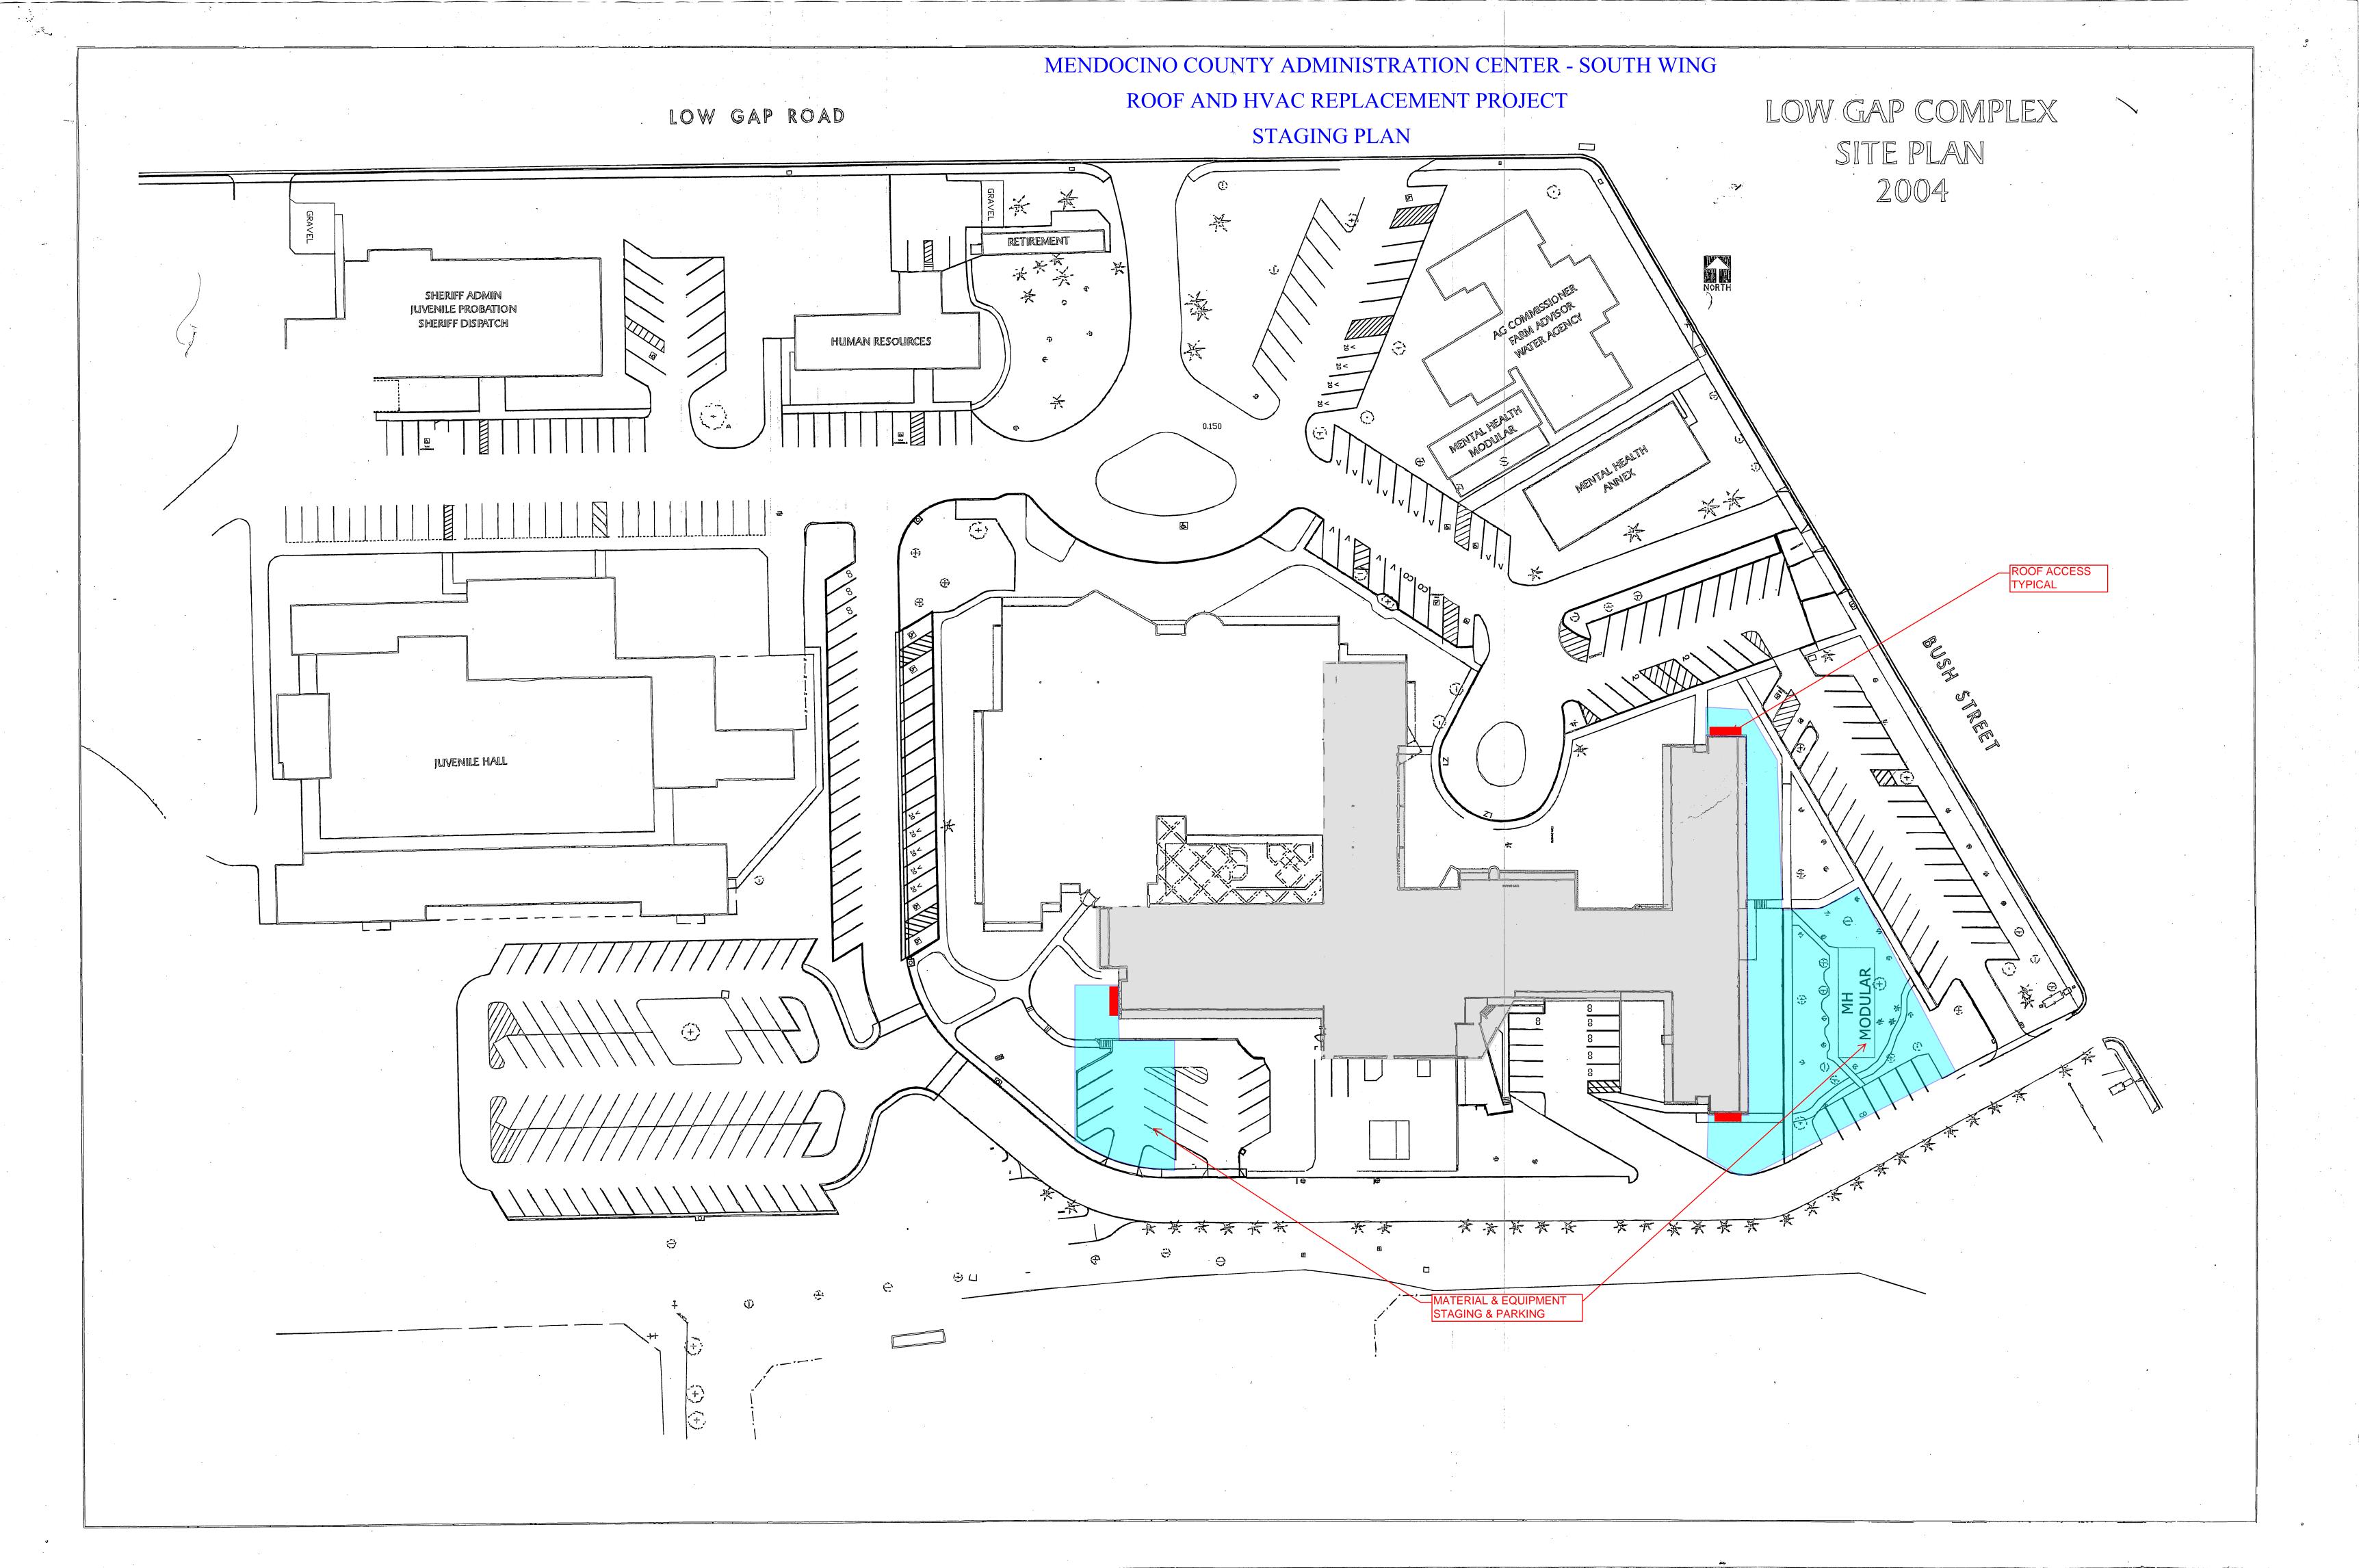

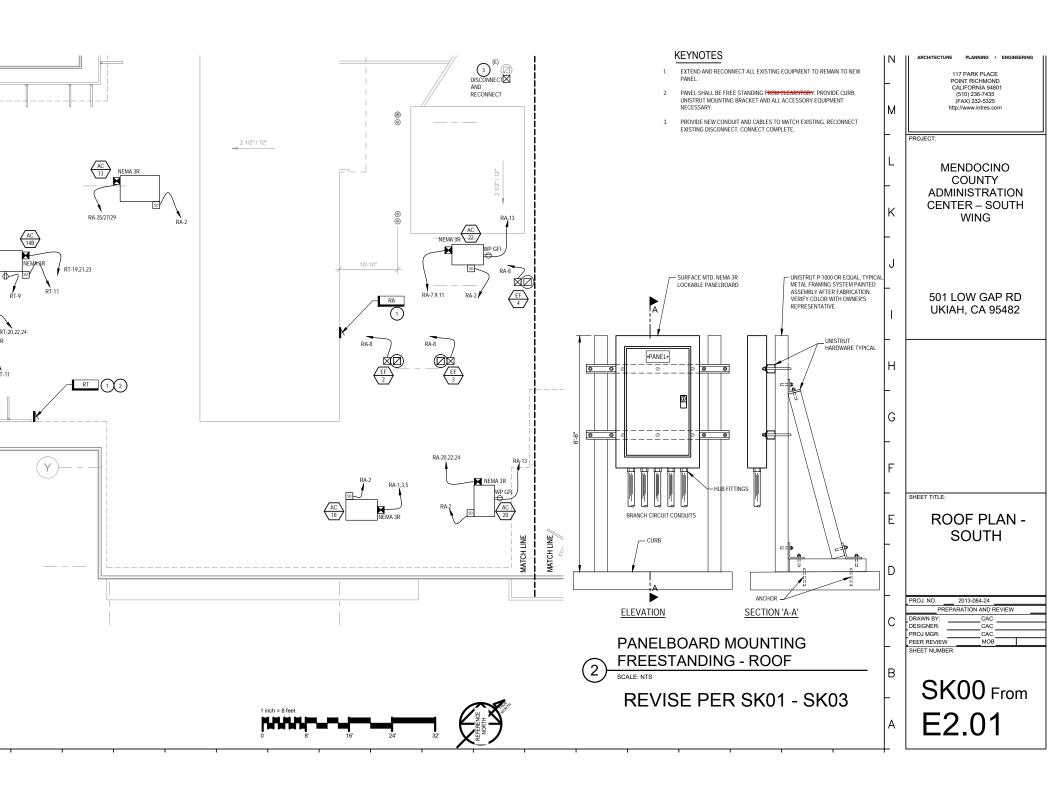

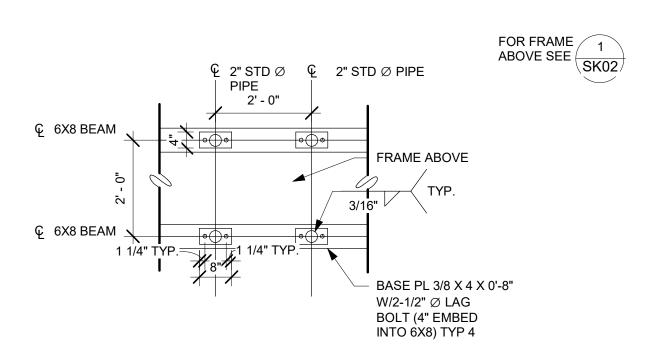






(N) ELECTRICAL PANEL SUPPORT FRAME AT BASE


1/2" = 1'-0"

INTERACTIVE	MENDOCINO COUNTY ADMINISTRATION	APPLICATION NO.	JOB NO. 2013-084-26
R E S O U R C E S	CENTER – SOUTH WING	FILE NO.	
117 PARK PLACE	860 N. BUSH STREET UKIAH, CA 95482	DRAWN BY: SER	SK01
POINT RICHMOND CALIFORNIA 94801	STRUCTURAL DETAIL - ELECTRICAL PANEL SUPPORT FRAME	SCALE: 1/2" = 1'-0"	
(510) 236-7435 (FAX) 232-5325		DATE: 11/17/17	

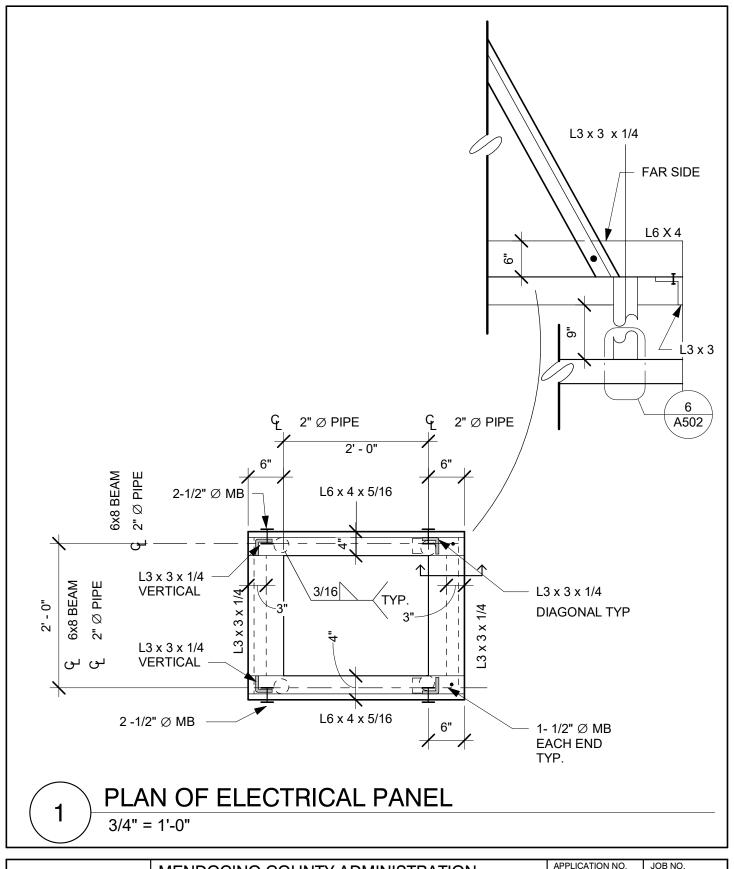

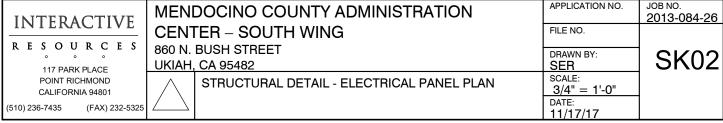

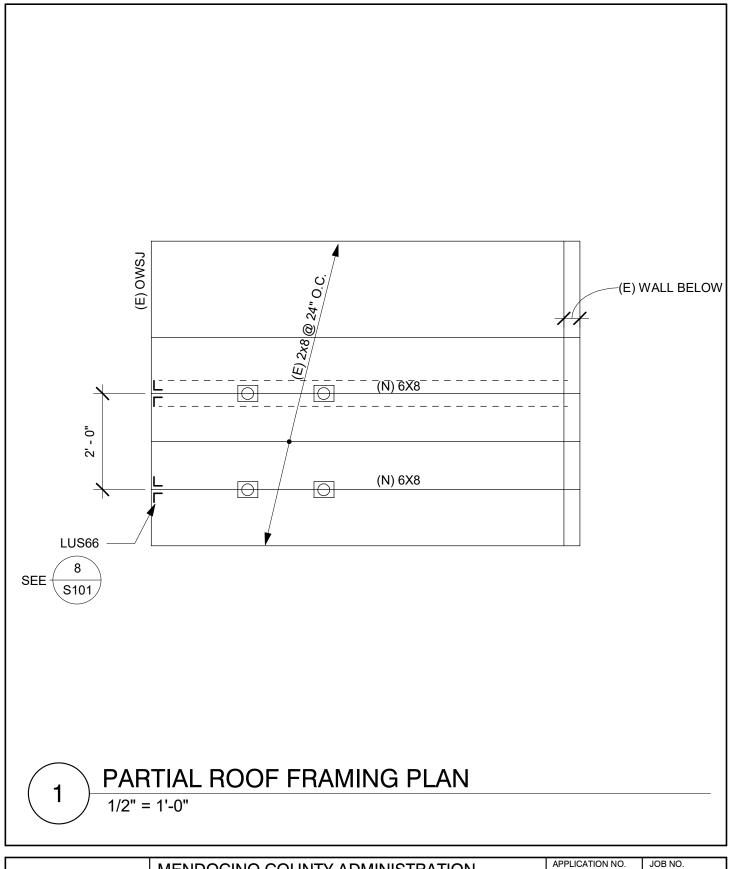

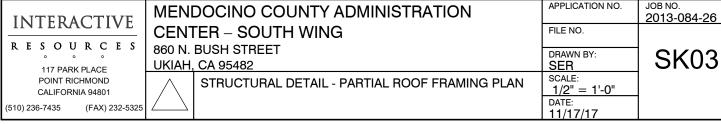

MENDOCINO COUNTY FACILITIES & FLEET DIVISION SITE WALK-THRU ATTENDANCE SHEET for the project:

MENDOCINO COUNTY ADMINISTRATION CENTER SOUTH WING

ROOF AND HVAC REPLACEMENT PROJECT

Thursday, November 9, 2017 11:00 AM

Print Name	Signature	Compai	ny	Phone #		Email
Mike Oglesby	Make De	Okiah Electore		707 462-1660	elector	Qukahconstruction com
Jose A. Medina	Mke Se Soe A. Medine	500thwest	construccion	650 877 0717	ot @	southwesterm. com
DAVID IM DORK						RDHEZOK OGMALLA
97.2	S					
						,
			9		,	
						, i

MENDOCINO COUNTY FACILITIES & FLEET DIVISION SITE WALK-THRU ATTENDANCE SHEET for the project:

MENDOCINO COUNTY ADMINISTRATION CENTER SOUTH WING

ROOF AND HVAC REPLACEMENT PROJECT

Monday, November 20, 2017 1:00 PM

Print Name	Signature	Company	Phone #	Email
CHRIS HEMPHILL	Cholin	DURO-UAST REG-	570-507-944	46 CHREEDINISION TREA
Chaire Slave	Chas	Curs can Strateur Gar are	599 5085	cusconstration Occoncastin
Chare Slave Chare Slave Casey Cupples		Capples of Sons Const Inc	707 467 - 0674	CUSCONSTRUCTION OCCURCANTION OC
				v.
		,		