



COUNTY OF MENDOCINO
Executive Office
Facilities & Fleet Division

CARMEL J. ANGELO
CHIEF EXECUTIVE OFFICER

851 Low Gap Road
Ukiah, CA 95482

Email: andersond@mendocinocounty.org
Website: www.mendocinocounty.org

Office: (707) 234-6050
Fax: (707) 463-4673

ADDENDUM #: 2

PROJECT: Willits Veterans Hall Accessible Ramps

DATE: 9-8-2017

ISSUED BY: Doug Anderson

The additions, omissions, clarifications, and/or corrections herein shall be made part of the Contract plans and specifications and shall be included in the Scope of Work and proposals to be submitted. This Addendum modifies the original plans and specifications as described below.

INQUIRIES AND CLARIFICATIONS TO PROJECT PLANS AND SPECIFICATIONS

1. **Q:** New ramp passes through existing fence and gate, will the fence be abandoned or reinstalled at a different location?

A: Remove fencing as required to install ramp, provide new fencing and gates as shown in the attached sheet ADD 2.1

2. **Q:** Exterior Lighting shown at 10' 3" (presumably above grade) conflicts with existing window locations, please clarify fixture locations.

A: Center fixtures in space above windows, typical except as noted; see attached sheets ADD 2.2 and ADD 2.3

3. **Q:** Existing gas line to the furnace unit and interior appliances is mounted to the (E) metal lean-to shed to be demolished, please provide direction for gas service.

A: Intercept (E) gas service below grade outside excavations for new work; provide new gas line under slab. Provide (N) connection and SOV for relocated furnace and reconnect to existing through wall penetration. See attached sheet ADD 2.1

ADDITIONAL INFORMATION

Remove Plan Sheet A102 Site Plan-New and replace it with the attached ADD 2.1/A102 Site Plan-New.

Mandatory Walk-through attendees are listed on the attached Sign in Sheet. Bids will not be accepted from contractors who did not attend.

The date for receiving bids is unchanged.

Bidders are reminded that they shall complete the Addenda Acknowledgement in the Bid Form of their Specification Book (Section 00310-2). Failure to do so may result in disqualification of the submitted bid.


A

B

C

D


E

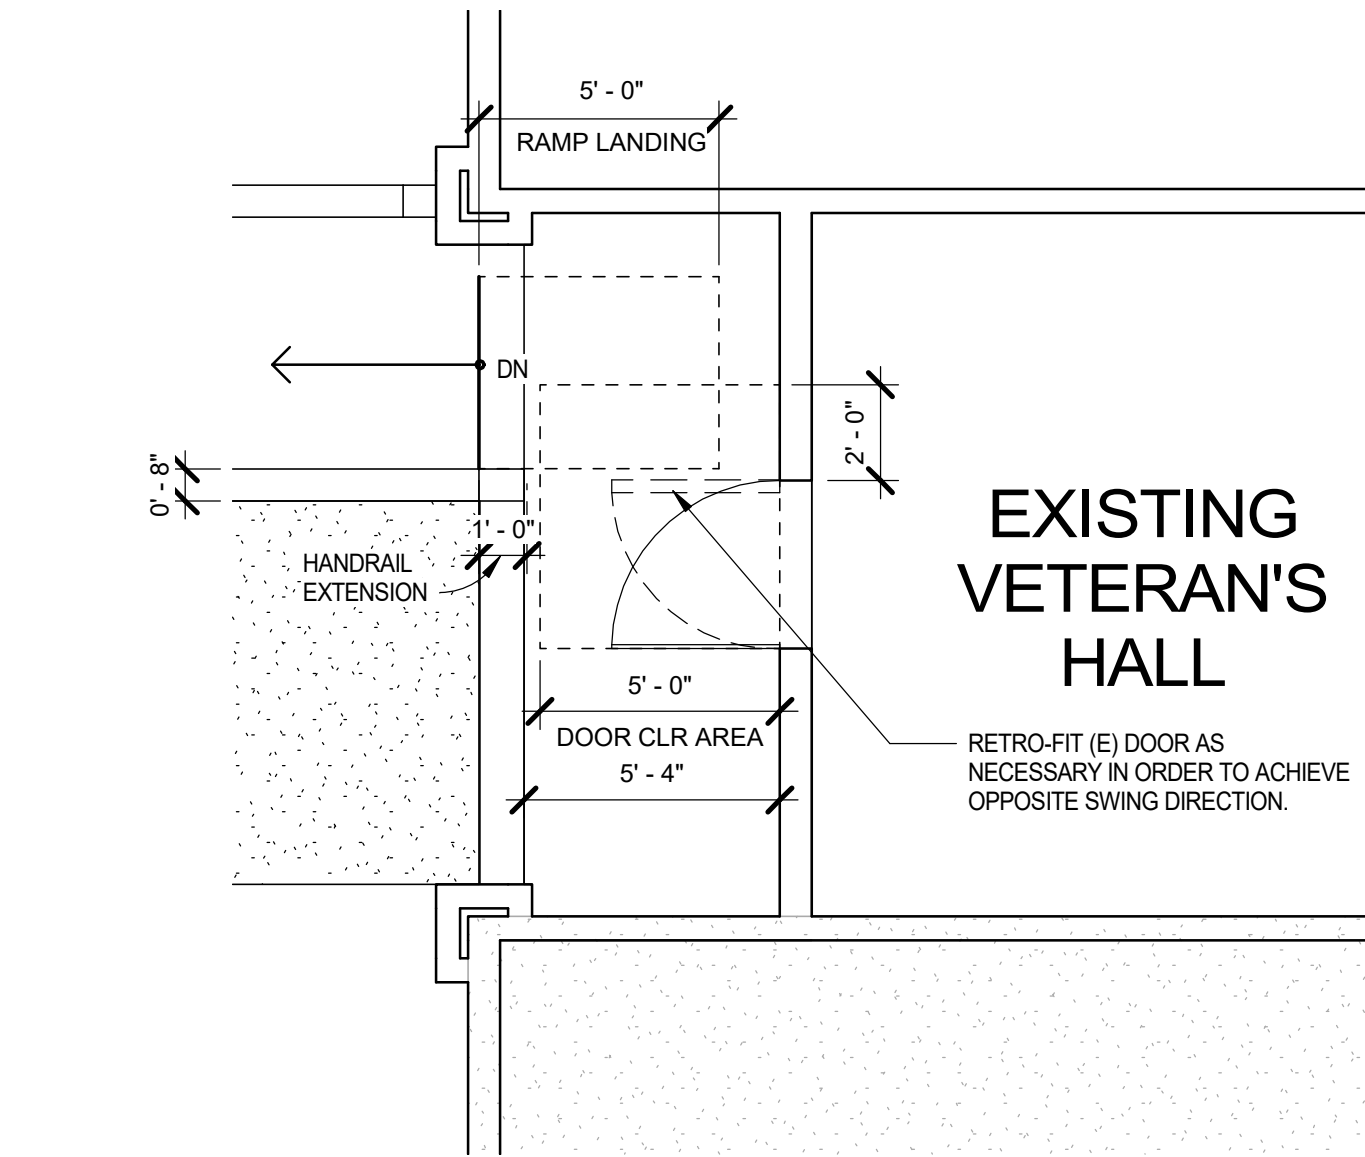

2 FRONT ENTRANCE PLAN
1/4" = 1'-0"



SEE CIVIL DWGS FOR ACCESSIBLE PARKING AND PATH-OF-TRAVEL REQUIREMENTS; GRAPHICS SHOWN ARE ONLY FOR REF..

NORTH MAIN ST.

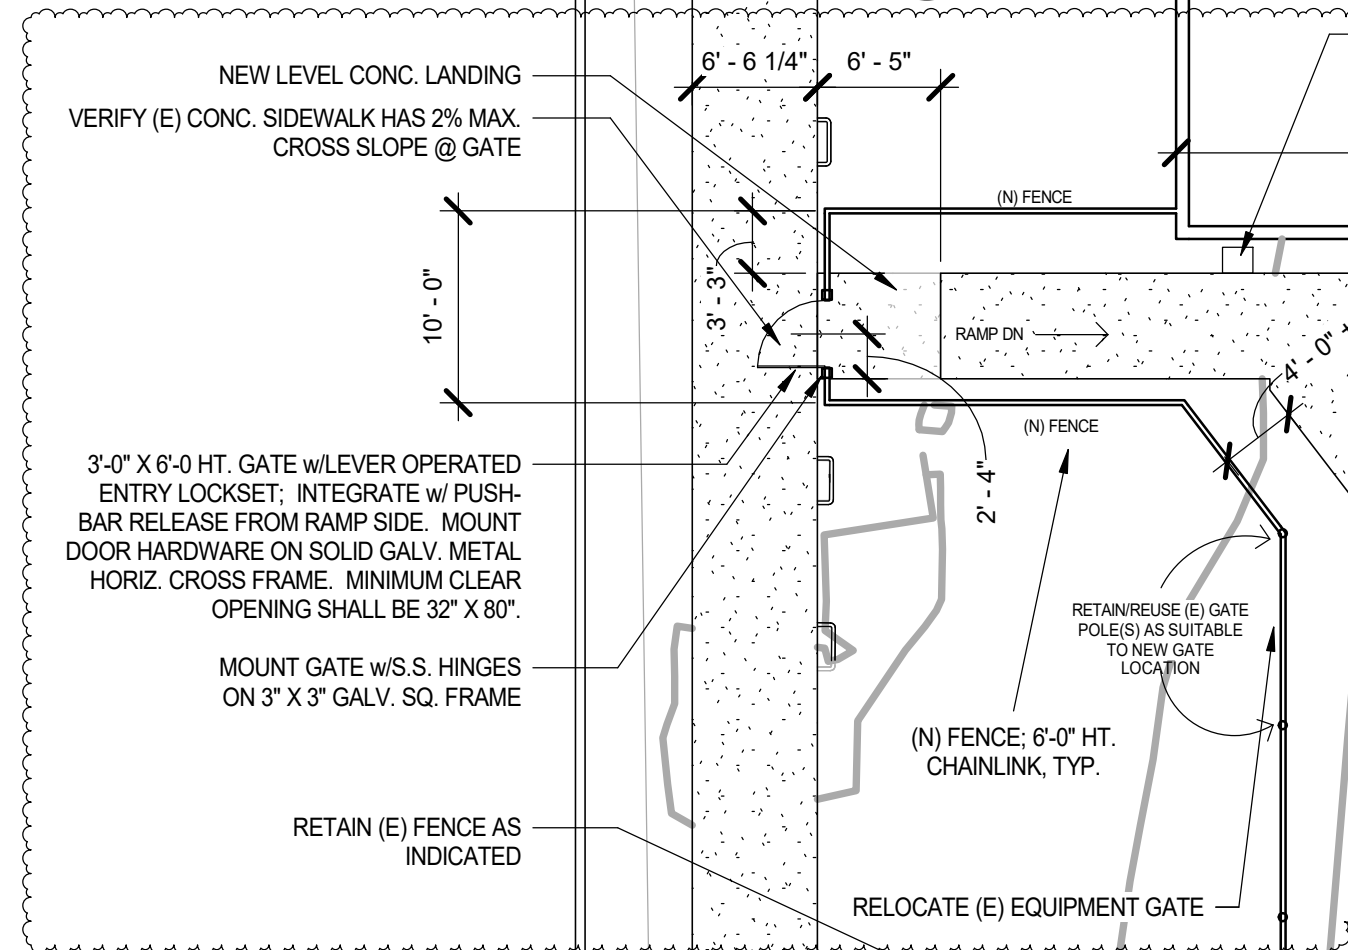

1 SITE PLAN
1" = 10'-0"

1 inch = 10 feet

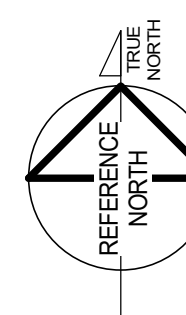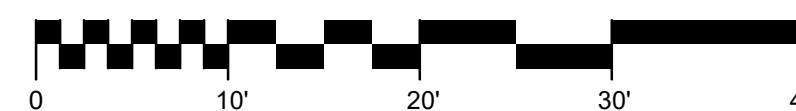

REVISION SCHEDULE		
NO.	DESCRIPTION	DATE
1	Add Fence & Gate	9/7/2017

SEAL:

CONSULTANT:

BrokawDesign
P.O. BOX 3103
ROHNERT PARK, CA 94927
WWW.BROKAWDESIGN.COM

PROJECT:
ACCESSIBLE RAMPS
WILLITS VETERAN'S MEMORIAL BUILDING

189 NORTH MAIN STREET
WILLITS, CA 95490

SHEET NAME:
SITE PLAN - NEW

ISSUE DATE:	8/16/2017
PREPARATION AND REVIEW	
DRAWN BY:	Author
DESIGNER:	Designer
PROJ MGR:	CLB
PEER REVIEW:	Checker

SHEET NUMBER:
**ADD 2.1
A102**

VETERANS MEMORIAL BUILDING

1940

WOMENS AUX
UNIT 174

MEETING
2ND TUE

WILLITS UNIF. SCHOOL DIST
NO TOBACCO
TOBACCO FREE SCHOOL DIST.
BP 0012.2

ADD 2.2

Conceal conduit
above feature band.

Center light fixture
above the window
in feature band.



Conceal conduit in
shadow of feature band

Center light fixtures in
space above windows

Locate light fixture on
corner trim at 10' 3"
above ramp grade

ADD 2.3

for the project:

Warren Hall Accessible
Main Street, Willits
by August 31, 2017, 1

Thursday August 31, 2017, 10:00 AM

[illegible]